

DOCUMENT 00911

**ADDENDUM NUMBER 1**

Issued: July 7, 2011

**KAWANA SPRINGS WATER STORAGE TANKS FENCE REPLACEMENT PROJECT**

FROM: Sonoma County Water Agency  
404 Aviation Blvd.  
Santa Rosa, CA 95403-9019

TO: Prospective Bidders

This Addendum forms a part of and modifies the Project Manual dated June 2011. Bidder shall acknowledge receipt of this Addendum in the space provided in Document 00400 (Bid Form).

Modified text is indicated as follows: Double-underline designates text to be inserted; ~~strikethrough~~ designates text to be deleted.

Addendum Number 1 consists of 2 pages (size 8 1/2" x 11") and 2 revised Drawings.

---

**I. General Changes**

A. No changes.

---

**II. Changes to Prior Addenda**

A. No changes.

---

**III. Changes to Introductory Information and Bidding Requirements**

A. No changes.

---

**IV. Changes to Contracting Requirements**

A. No changes.

---

**V. Changes to Conditions of the Contract**

A. Document 00800 (Supplementary Conditions)

1. Modify Paragraph 2 as follows, and re-number subsequent paragraphs accordingly:

A. Supplement to paragraph ~~4.2~~ 4.1:

---

**VI. Changes to Specifications**

A. Section 02821 (Chain Link Fence and Gates)

1. Delete Paragraph 3.1 B in its entirety.

---

**VII. Changes to Drawings**

- A. Delete Drawing C-1 and replace with attached Drawing C-1, marked "06-22-2011 ADDENDUM No. 1."
  - B. Delete Drawing D-1 and replace with attached Drawing D-1, marked "06-22-2011 ADDENDUM No. 1."
- 

**VIII. Question(s)/Answer(s)**

Owner's responses to Bidder questions shall be for the purposes of interpretation and clarification of the Contract Documents only, and shall not be construed as changing, superseding, or contradicting any express term in the Contract Documents. If any Bidder believes that a response to a question warrants a change in any term in the Contract Documents, the Bidder shall so request the change be made in writing addressed to Owner and received no later than the latest date for submitting Bidder questions. In the absence of a change in any term of the Contract Documents, the express terms of the Contract Documents shall have precedence. Bidder questions are listed below verbatim.

**A. Arrow Fencing**


- 1. Does the All-risk Course of Construction apply to this project? And is so what is that. I have read through the section 00800 and I do not understand that.  
Owner's response: Bid per Bid Documents.
- 2. Does the Professional Liability apply for this as well? Same as above, I don't understand if it applies.  
Owner's response: Bid per Bid Documents.
- 3. I have read the info on section 00800 and I do not see what Environmental Impairment Liability is. What is it and does it apply to this project?  
Owner's response: Bid per Bid Documents.

**B. Pisor Fence Division**

- 1. Spec.-section 02821, 3.1, B. notes the area to be graded before beginning fence installation. Who does the staking and/or grading, if any grading is needed?  
Owner's response: Answered in this Addendum above.

END OF DOCUMENT

\\sfd-data\p\water transmission\tanks\kawana\7474\_GENERAL.dwg

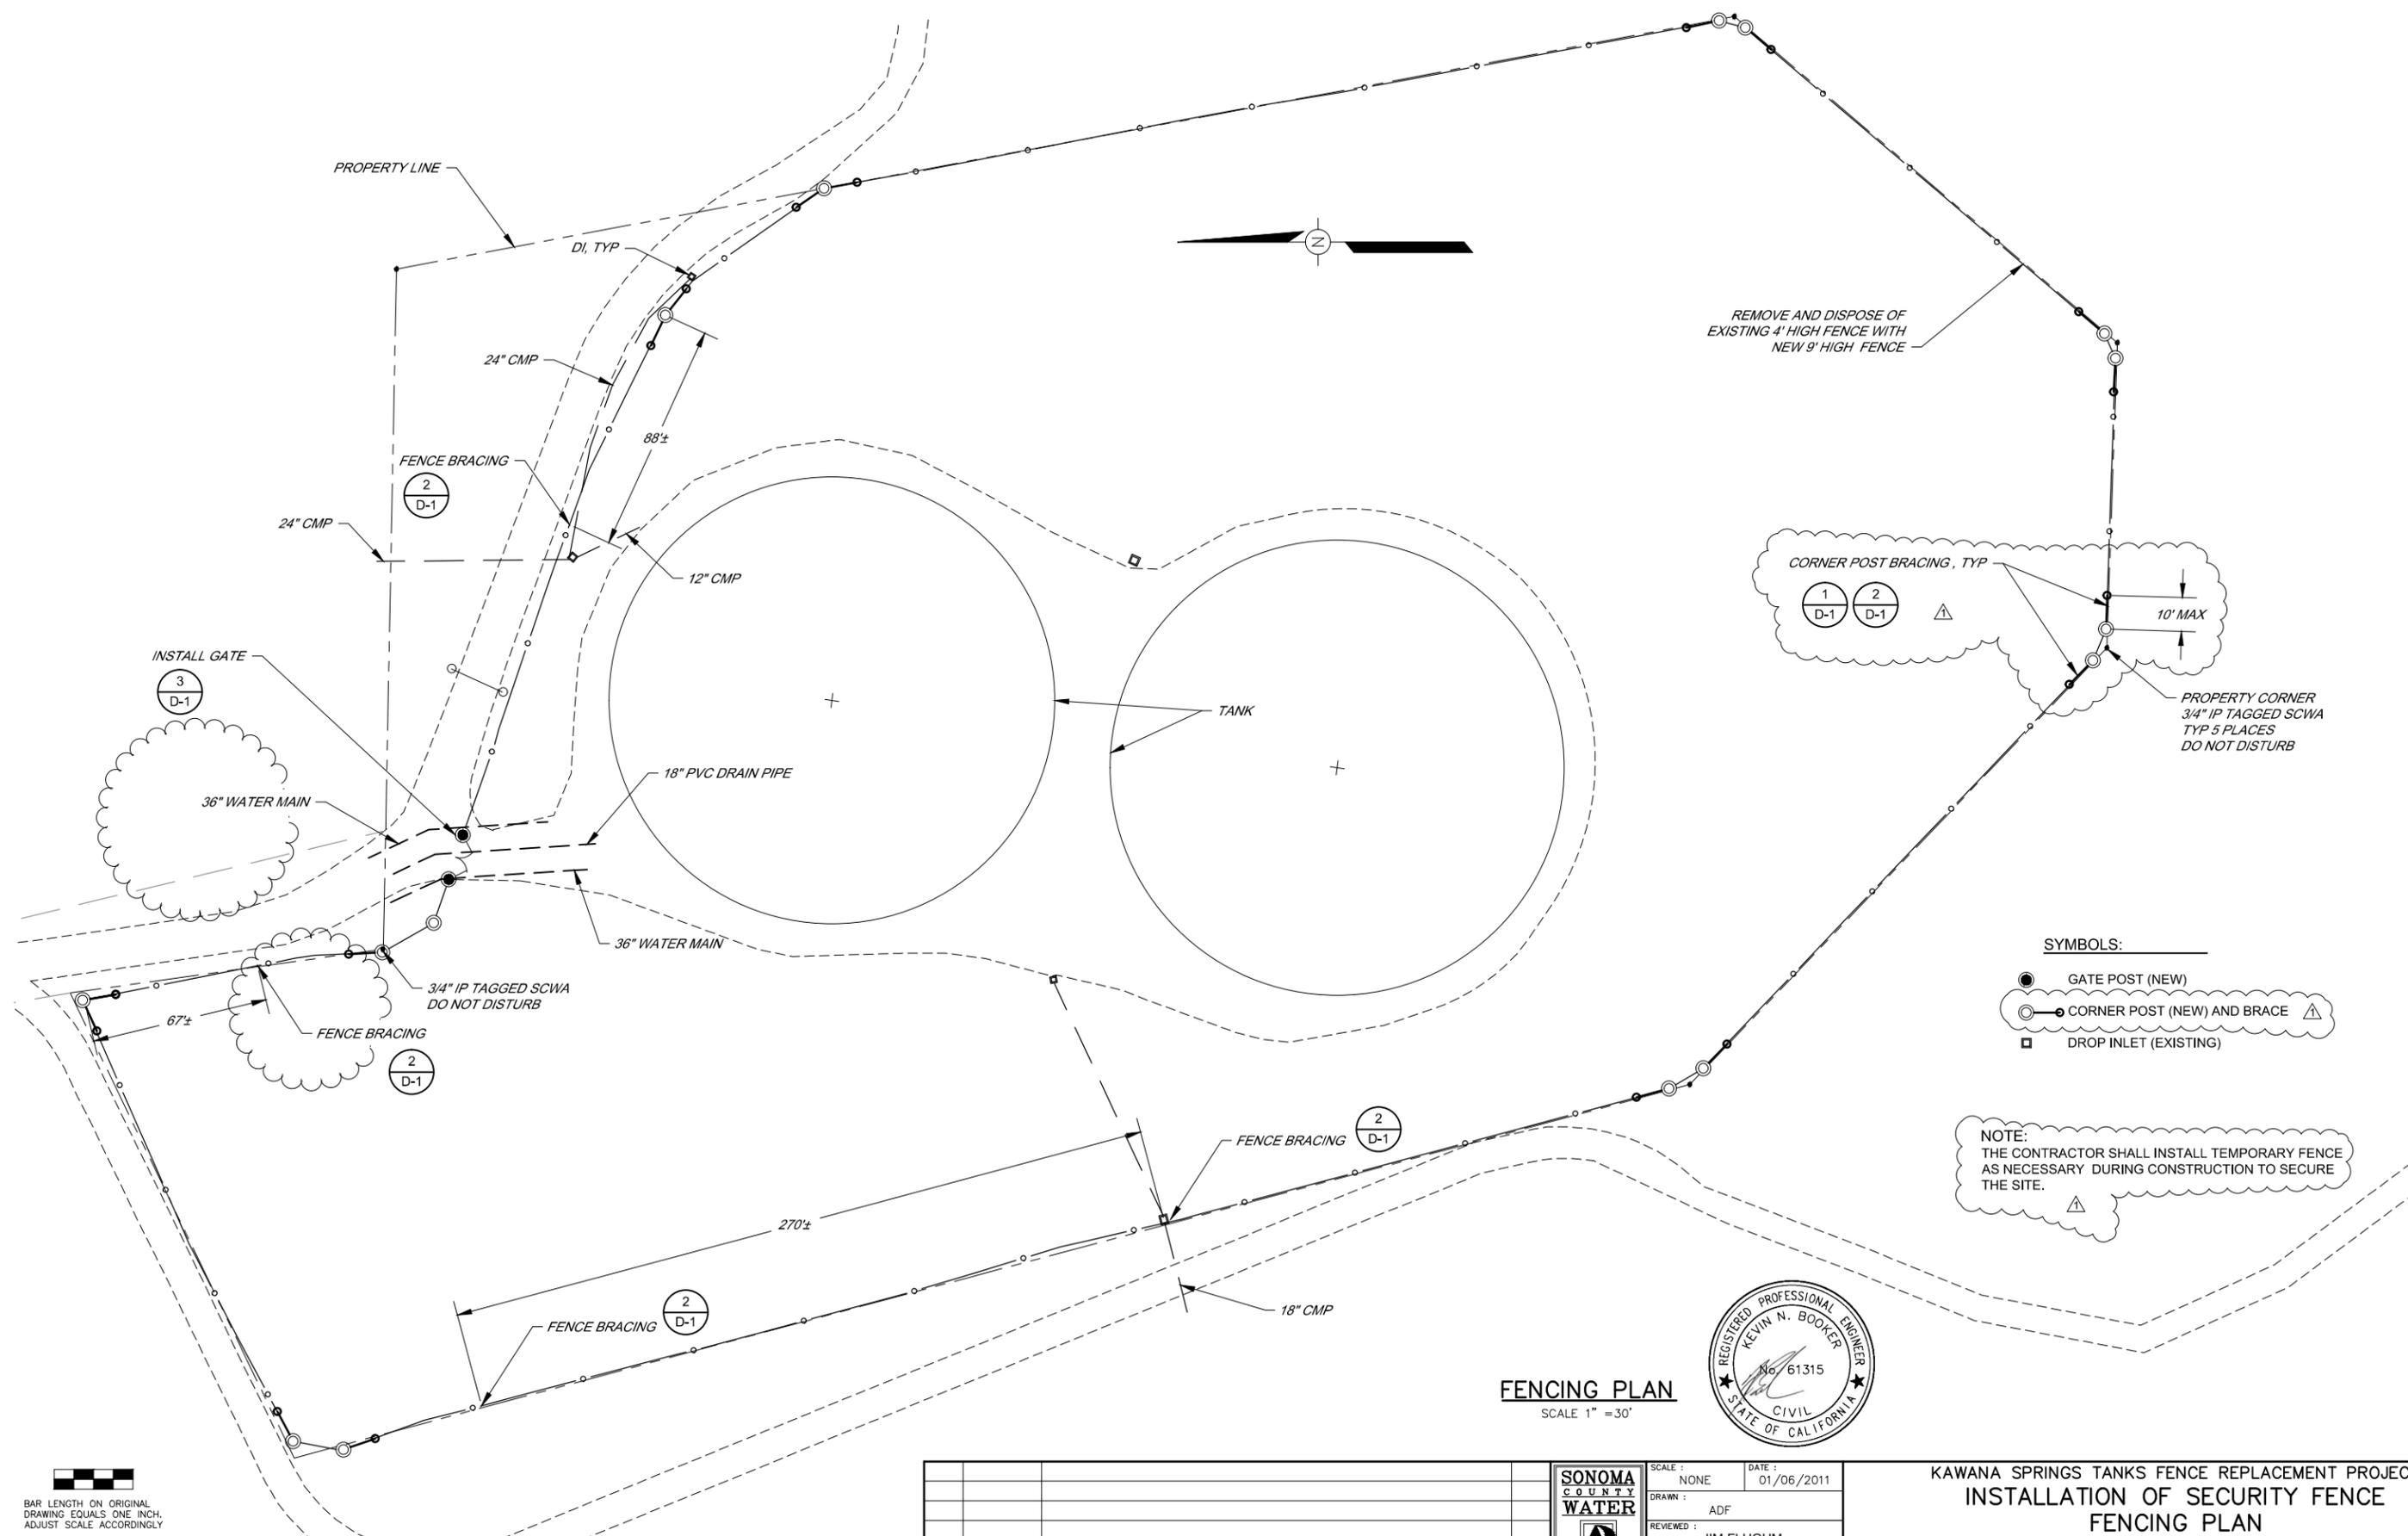


**FENCING PLAN**  
SCALE 1" = 30'

- SYMBOLS:**
- GATE POST (NEW)
  - CORNER POST (NEW) AND BRACE
  - DROP INLET (EXISTING)



**NOTE:**  
THE CONTRACTOR SHALL INSTALL TEMPORARY FENCE AS NECESSARY DURING CONSTRUCTION TO SECURE THE SITE.

BAR LENGTH ON ORIGINAL DRAWING EQUALS ONE INCH. ADJUST SCALE ACCORDINGLY



		SCALE: NONE DRAWN: ADF REVIEWED: JIM FLUGUM	DATE: 01/06/2011	<b>KAWANA SPRINGS TANKS FENCE REPLACEMENT PROJECT</b> <b>INSTALLATION OF SECURITY FENCE</b> <b>FENCING PLAN</b>	
NO. 6/22/2011 DATE	ADDENDUM NUMBER 1 REVISION	BY	FILE NAME: 7474_GENERAL.dwg CONTRACT NUMBER:	DRAWING NUMBER: C-1	SHEET 2 OF 3

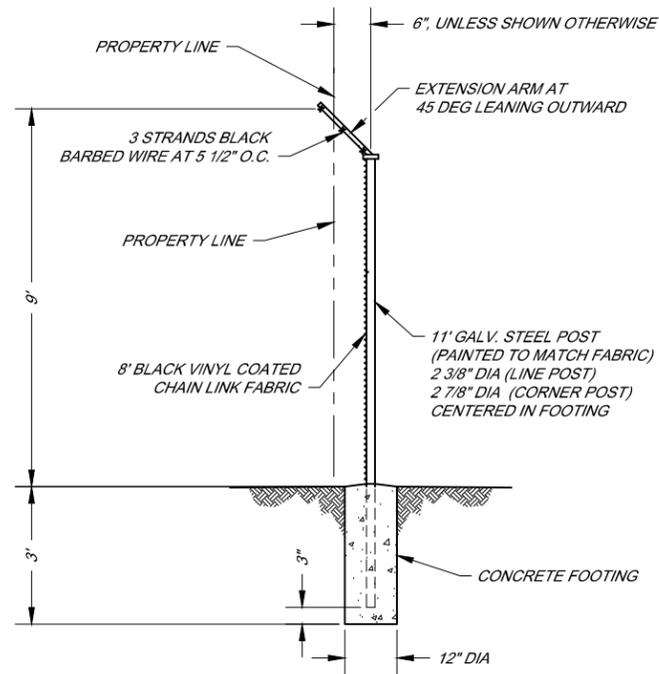


TYPICAL FENCE SECTION  
NOT TO SCALE

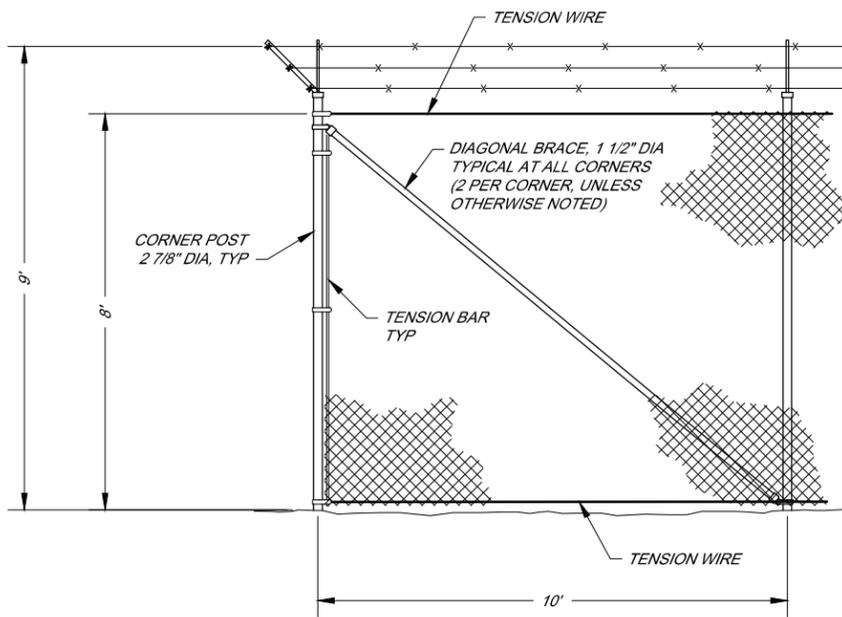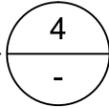


TYPICAL FENCE CORNER BRACING  
NOT TO SCALE

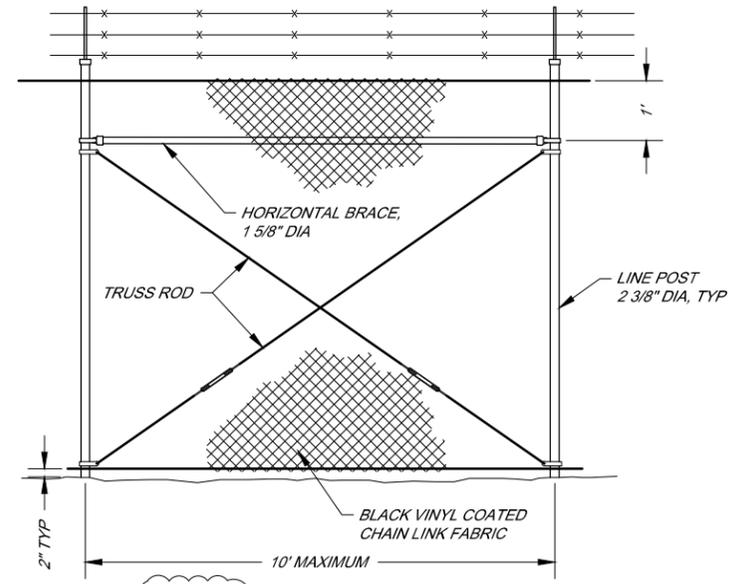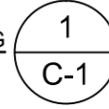


TYPICAL FENCE BRACING  
NOT TO SCALE

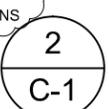


NOTE:  
LOCATED AS SHOWN ON DRAWING C-1  
BRACED AND TRUSSED IN BOTH DIRECTIONS

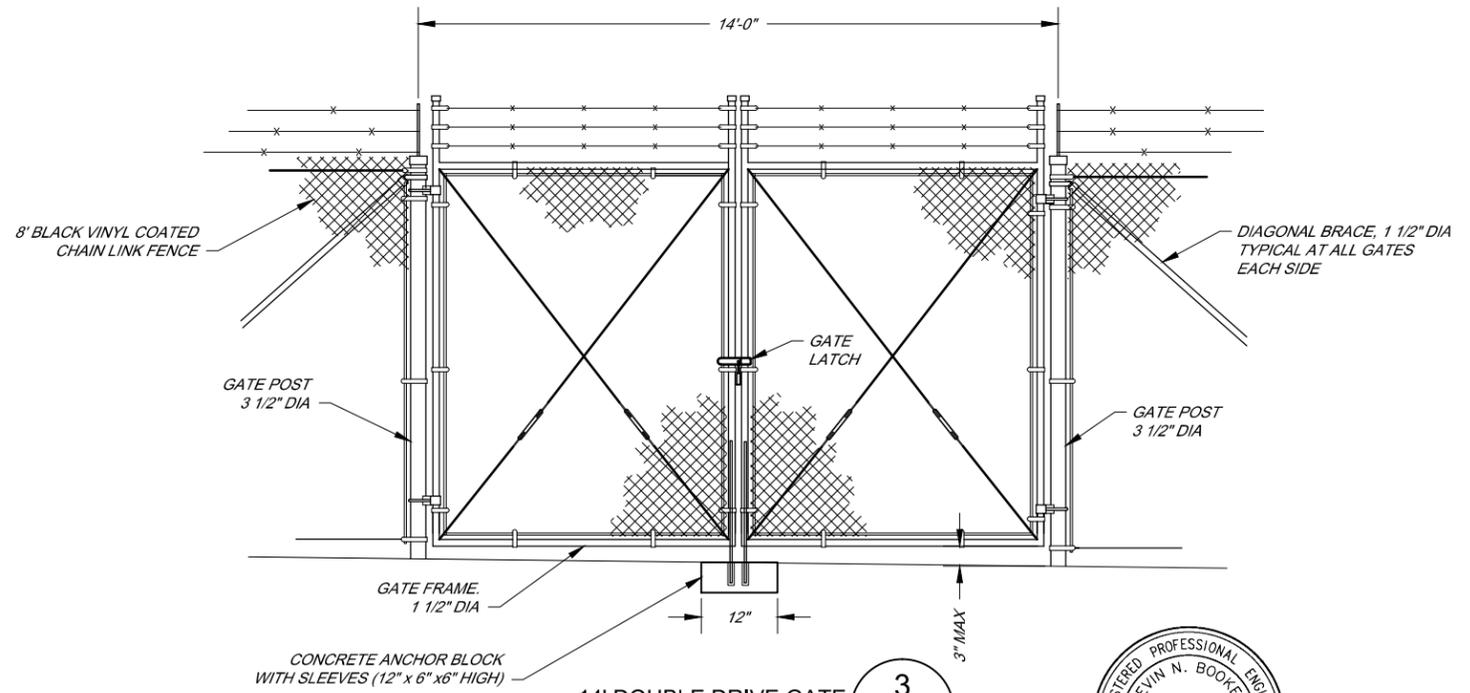

14' DOUBLE DRIVE GATE  
(1 REQUIRED)  
NOT TO SCALE

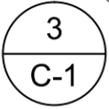

I:\SP-data\proj\water transmission\tanks\kavarna\7474\_FENCE\7474\_D-1.dwg 6/22/2011 2:31:59 PM

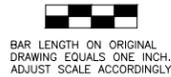

BAR LENGTH ON ORIGINAL  
DRAWING EQUALS ONE INCH.  
ADJUST SCALE ACCORDINGLY

NO.		DATE		REVISION		BY			SCALE : NONE	DATE : 24/05/2011	<b>KAWANA TANKS FENCE REPLACEMENT PROJECT INSTALLATION OF SECURITY FENCE FENCING DETAILS</b>		
22/6/2011		ADDENDUM NO. 1		JF		ADF			DRAWN :	REVIEWED : JIM FLUGUM			